


SPECTRUM BUILDING

613 NW LOOP 410, SAN ANTONIO, TX 78216


SUITE 850

2,741 RSF

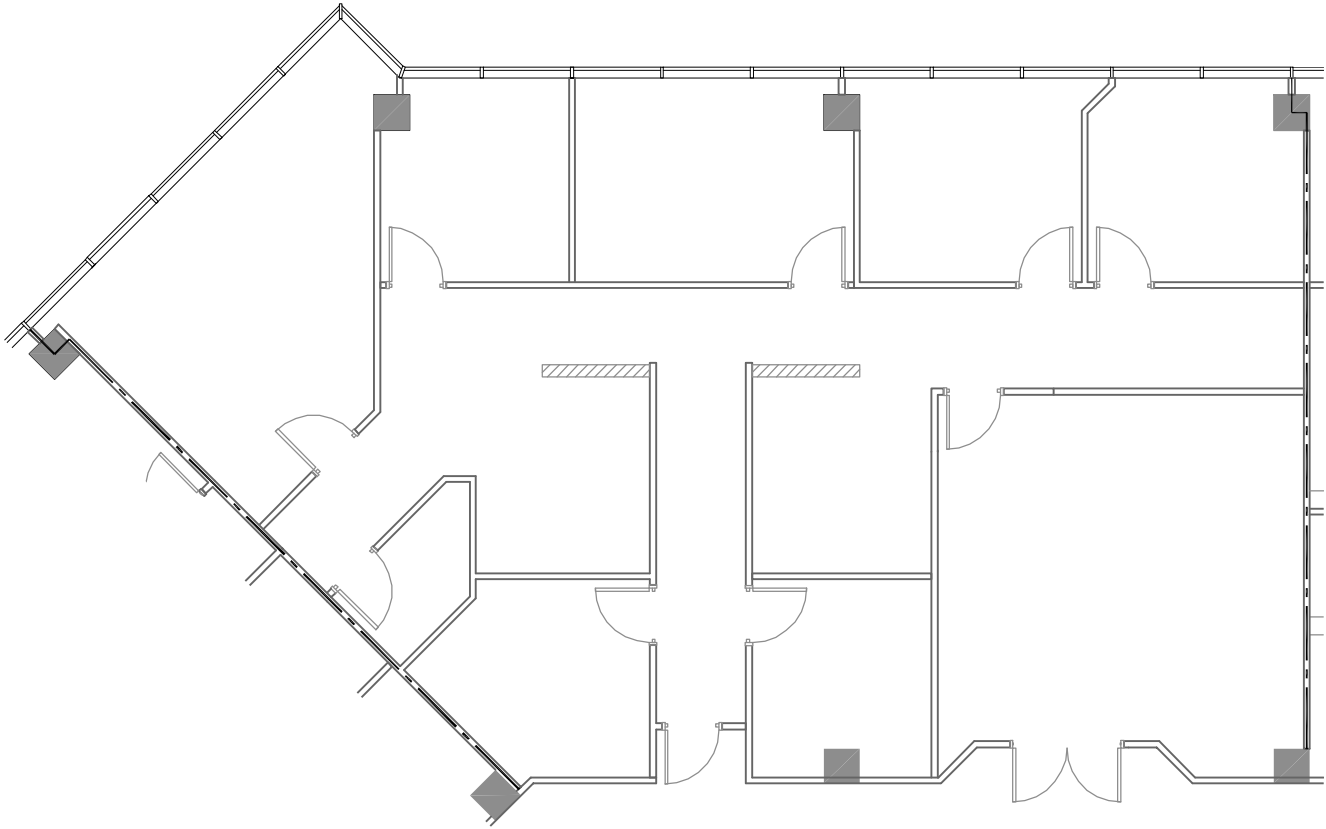

SCALE: 3/32" 1'-0"

LOCATION MAP

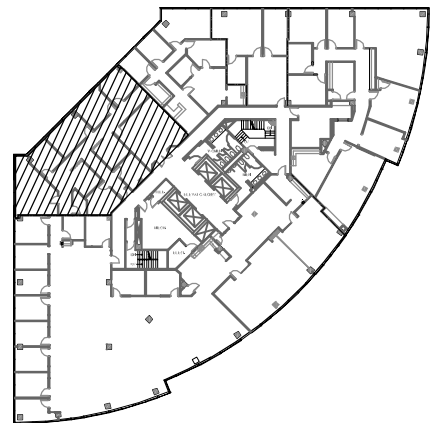

HARTMAN

(713) 467-222

WWW.HI-REIT.COM

I N S I T E
Architects

